BBMP

BRUHAT BANGALORE MAHANAGAR PALIKE

AS BUILT DRAWINGS

SECOND &FINAL BILL

IMPROVEMENTS TO ROADS, DRAINS AND OTHER DEVELOPMENTAL WORKS

PACKAGE - 08

Name of Work: Restoration and Improvements of roads at MS Palya, Aishwarya Bakery road, Giridhamanagara and surrounding areas in Ward no- 03 of Yelahanka New town Sub division. (PACKAGE NO-08).

3|S-W0488|S024616 dt: 22.12.22

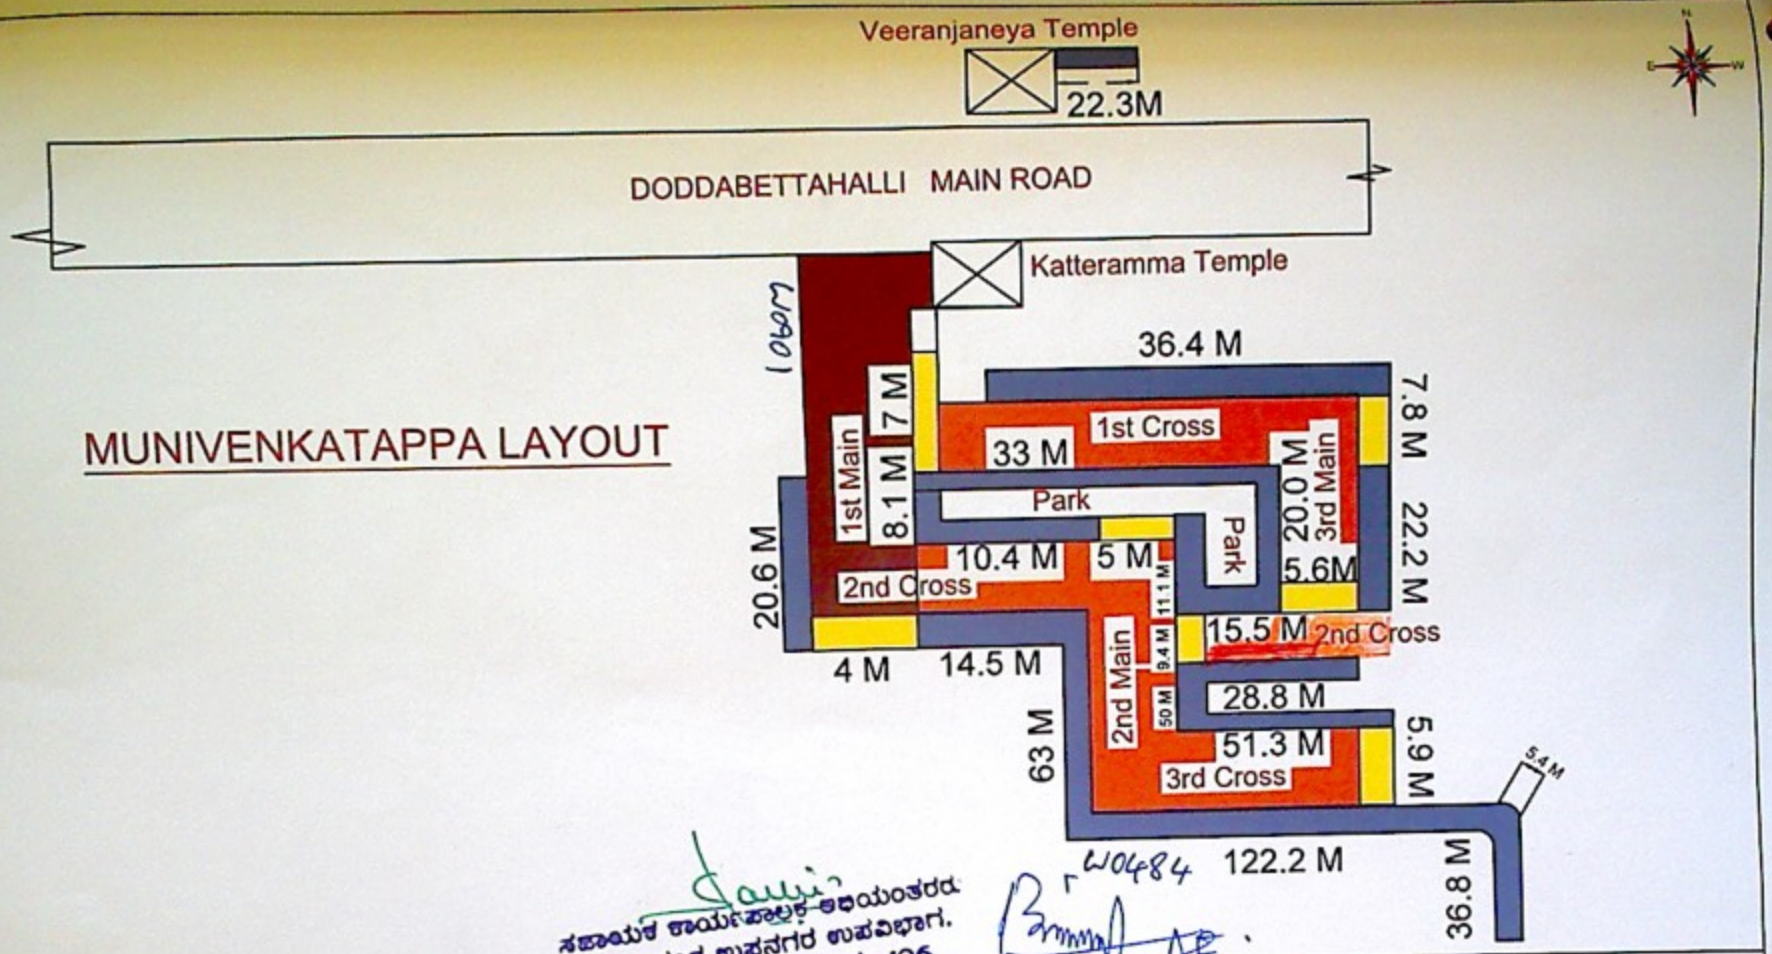

Location/Area/Ward: Munivenkatappa Layout - Ward 03	CLIENT: BBMP **The Executive Engineer** Yelahanka Division Bruhat Bengaluru Mahanagara Palike (BBMP) Bangalore - 560064	PMC: **NANDI CONSULTANTS** 1st Main, 2nd Cross, Krushinagar Shimoga-577204	CONTRACTOR: **SRI SAI Constructions**
PROJECT TITLE Restoration and Improvements of roads at MS Palya, Aishwarya Bakery Road, Giridhamanagara and Sorrounding Areas in Ward No. 03 of Yelahanaka New Town Sub Division (Package No 08)			

Note:
- FOR RCC DRAIN:
- FOR CULVERT:
- FOR ASPHALT ROAD:
- FOR CC ROAD:

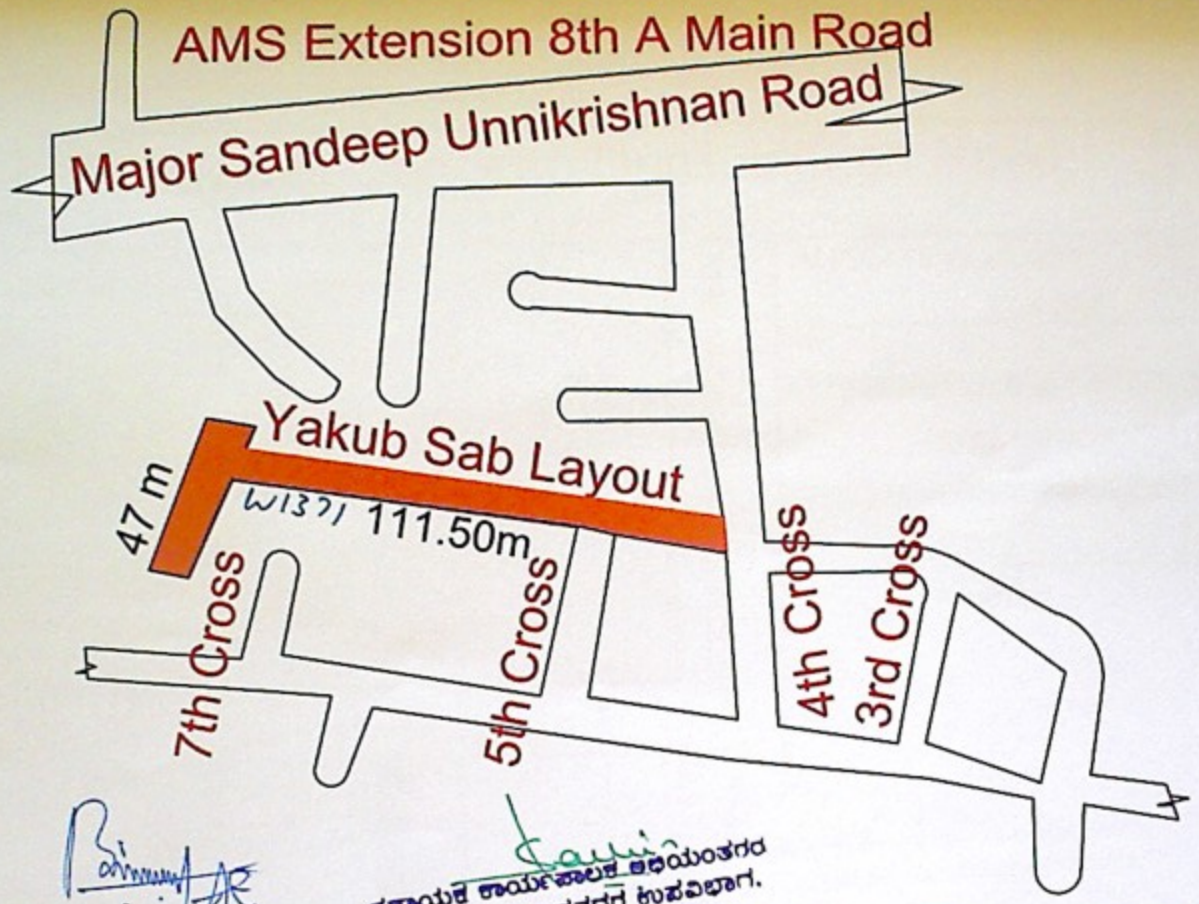

Location/Area/Ward: Ward no 3 - Yakub Sab Layout	CLIENT: ಬಿ.ಬಿ.ಎಂ.ಪಿ. ಬೆಂಗಳೂರು	PMC:	CONTRACTOR:	Note:
PROJECT TITLE Restoration and Improvements of roads at MS Palya, Aishwarya Bakery Road, Giridhamanagara and Sorrounding Areas in Ward No. 03 of Yelahanaka New Town Sub Division (Package No 08)	**The Executive Engineer** Yelahanka Division Bruhat Bengaluru Mahanagara Palike (BBMP) Bangalore - 560064	**NANDI CONSULTANTS** 1st Main, 2nd Cross, Krushinagar Shimoga-577204	**SRI SAI Constructions**	FOR ASPHALT ROAD:

ಸಹಾಯಕ ಕಾರ್ಯಪಾಲಕ ಅಭಿಯಂತರರ
ಯಲಹಂಕ ಉಪನಗರ ಉಪವಿಭಾಗ.
ಬೆಂಗಳೂರು-106

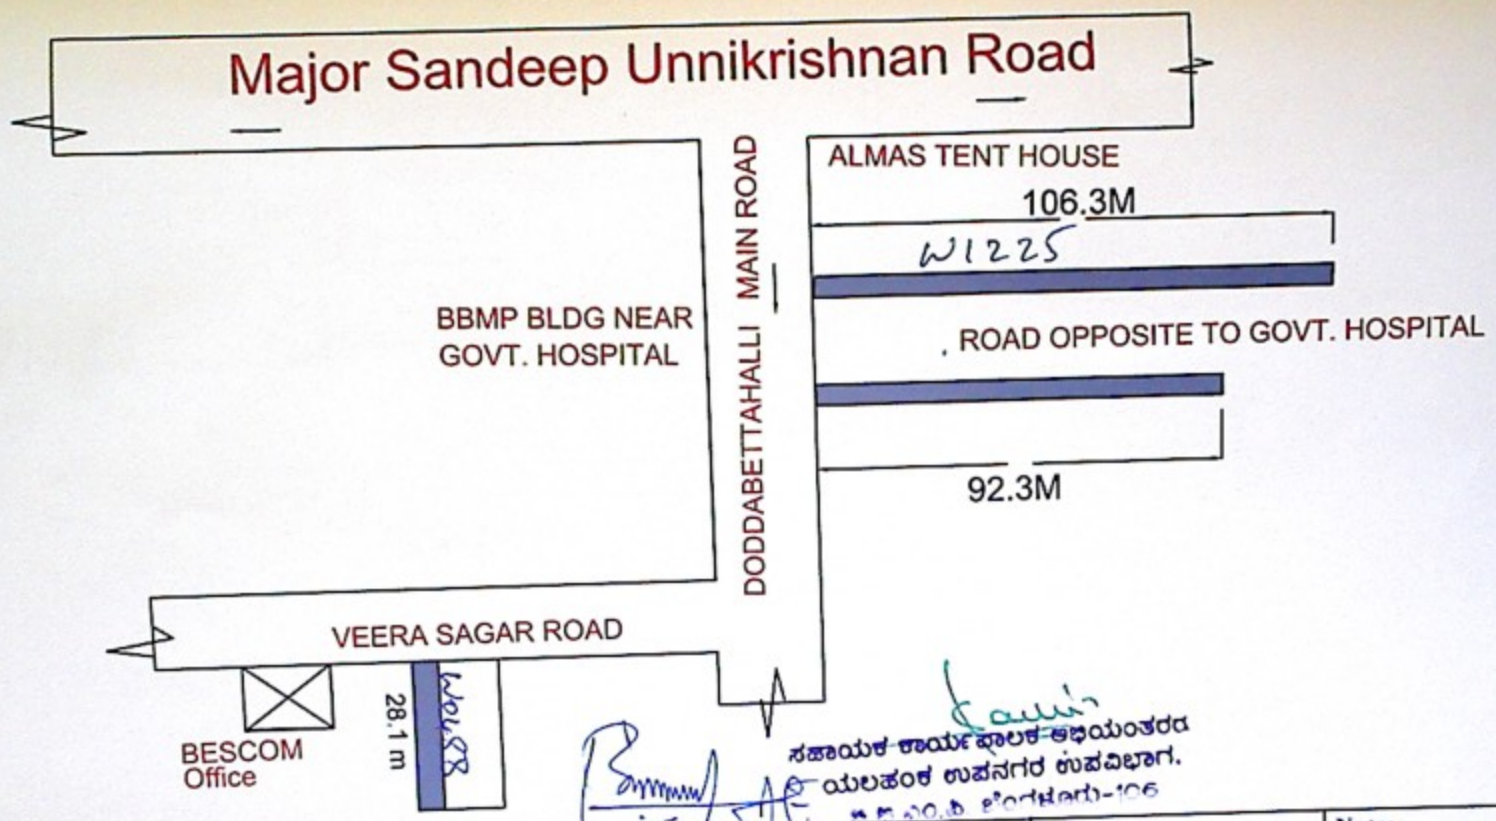

ಸಹಾಯಕ ಕಾರ್ಯಪಾಲಕ ಅಭಿಯಂತರರ
ಯಲಹಂಕ ಉಪನಗರ ಉಪವಿಭಾಗ.

Location/Area/Ward: Doddabettahalli Main Road- Ward 03	CLIENT: BBMP **The Executive Engineer** Yelahanka Division Bruhat Bengaluru Mahanagara Palike (BBMP) Bangalore - 560064	PMC: **NANDI CONSULTANTS** 1st Main, 2nd Cross, Krushinagar Shimoga-577204	CONTRACTOR: **SRI SAI Constructions**	Note: FOR RCC DRAIN:
PROJECT TITLE Restoration and Improvements of roads at MS Palya, Aishwarya Bakery Road, Giridhamanagara and Sorrounding Areas in Ward No. 03 of Yelahanaka New Town Sub Division (Package No 08)				

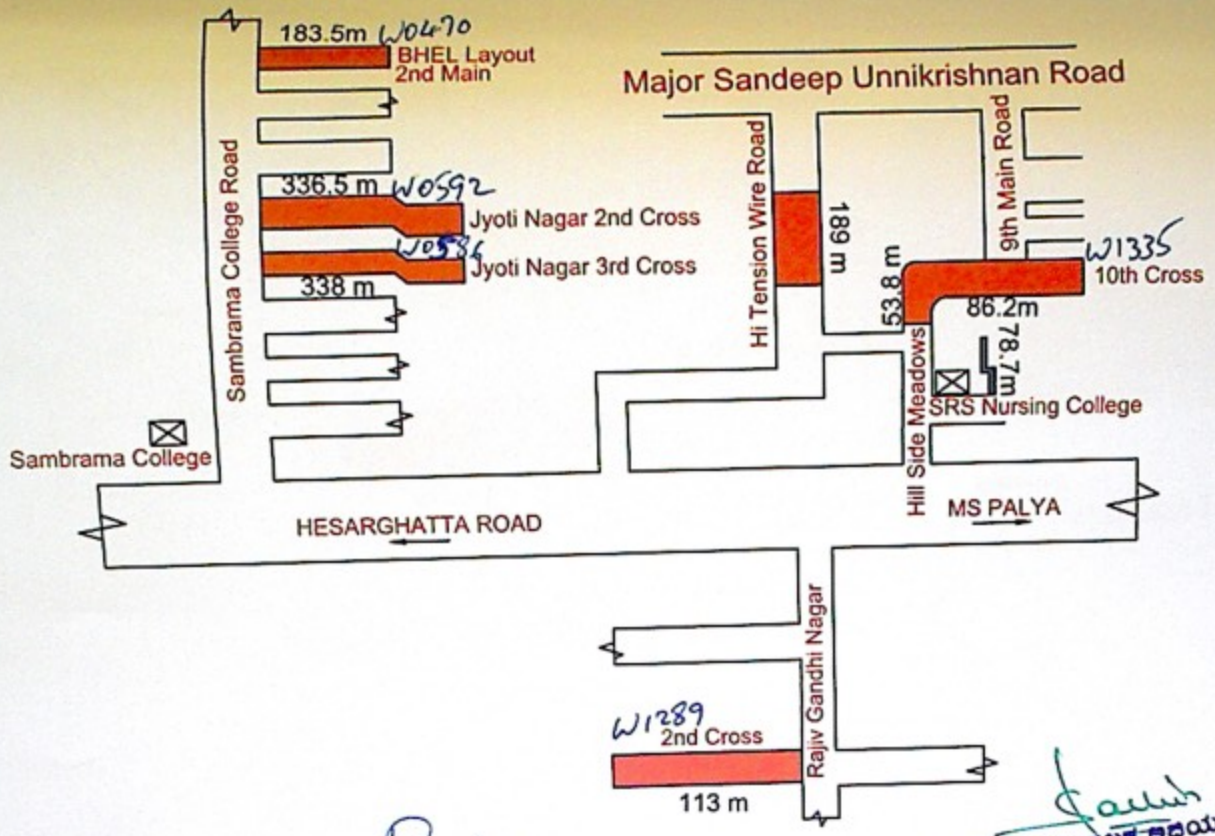

ಕಾರ್ಯಪಾಲಕ ಅಭಿಯಂತರರು
ಯಲಹಂಕ ಉಪನಗರ ಉಪವಿಭಾಗ
ಬಿ.ಬಿ.ಎಂ.ಪಿ. ಬೆಂಗಳೂರು-106

Location/Area/Ward: **Doddabettahalli-02 Ward 03**	CLIENT: BBMP	PMC: NANDI CONSULTANTS	CONTRACTOR: SRI SAI Constructions	Note: FOR ASPHALT ROAD:
PROJECT TITLE Restoration and Improvements of roads at MS Palya, Aishwarya Bakery Road, Giridhamanagara and Sorrounding Areas in Ward No. 03 of Yelahanaka New Town Sub Division (Package No 08)	**The Executive Engineer** Yelahanka Division Bruhat Bengaluru Mahanagara Palike (BBMP) Bangalore - 560064	**NANDI CONSULTANTS** 1st Main, 2nd Cross, Krushinagar Shimoga-577204	**SRI SAI Constructions**	

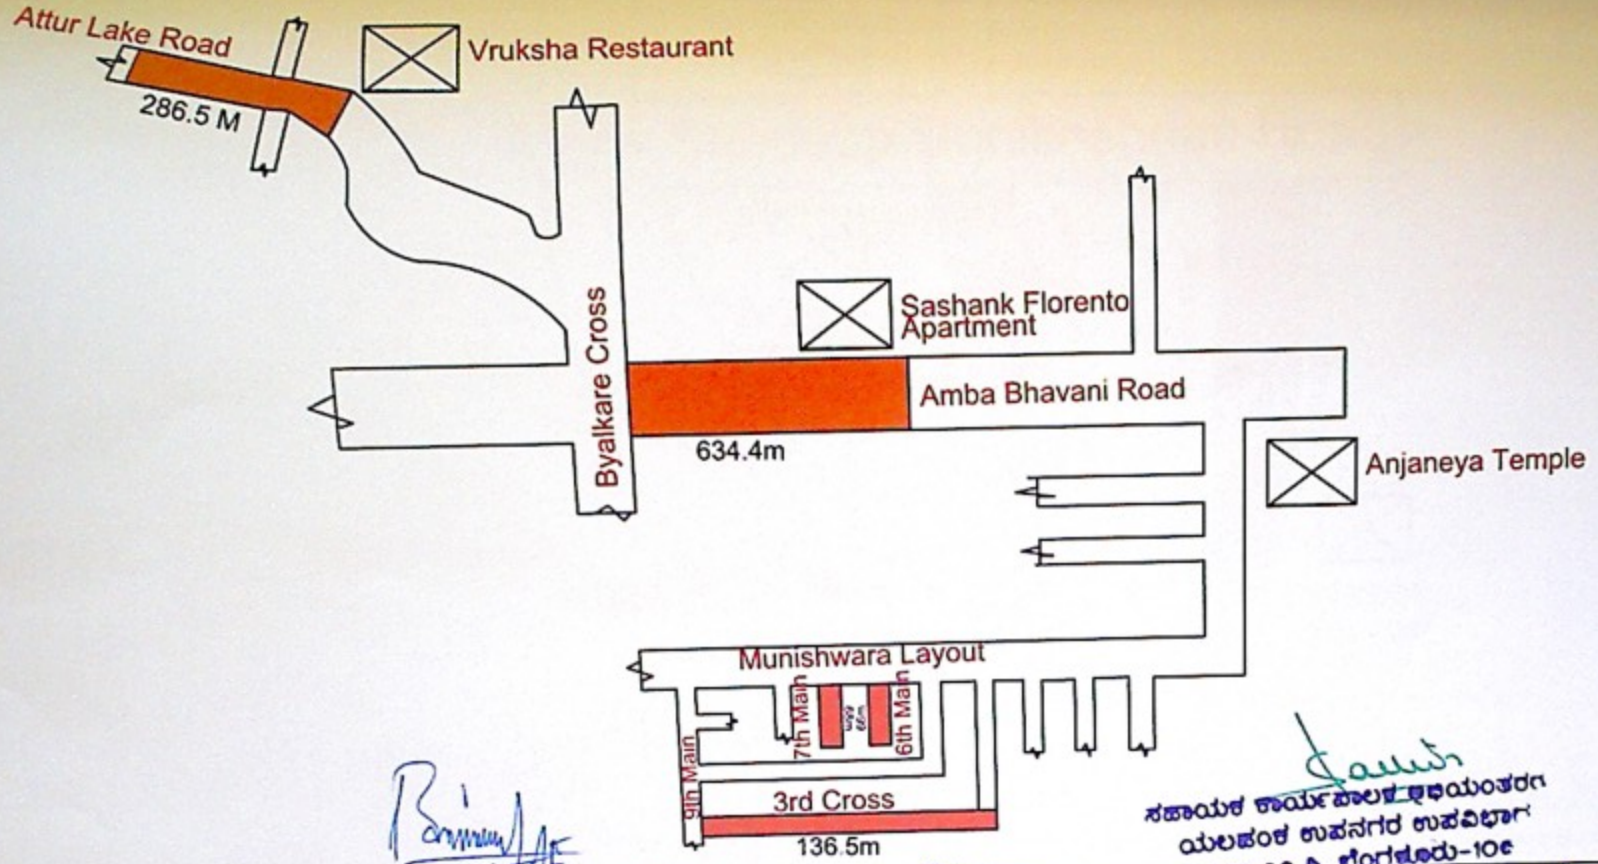

ಸಹಾಯಕ ಕಾರ್ಯಪಾಲಕ ಇಂಜಿನಿಯರರು
ಯಲಹಂಕ ಉಪನಗರ ಉಪವಿಭಾಗ
ಬಿ.ಬಿ.ಎಂ.ಪಿ. ಬೆಂಗಳೂರು-106

Location/Area/Ward: Doddabettahalli-01 Ward 03	CLIENT: BBMP	PMC: NANDI CONSULTS	CONTRACTOR:	Note:
PROJECT TITLE Restoration and Improvements of roads at MS Palya, Aishwarya Bakery Road, Giridhamanagara and Sorrounding Areas in Ward No. 03 of Yelahanaka New Town Sub Division (Package No 08)	**The Executive Engineer** Yelahanka Division Bruhat Bengaluru Mahanagara Palike (BBMP) Bangalore - 560064	**NANDI CONSULTANTS** 1st Main, 2nd Cross, Krushinagar Shimoga-577204	**SRI SAI Constructions** SRI SAI CONSTRUCTIONS JSC Bangalore	FOR ASPHALT ROAD:

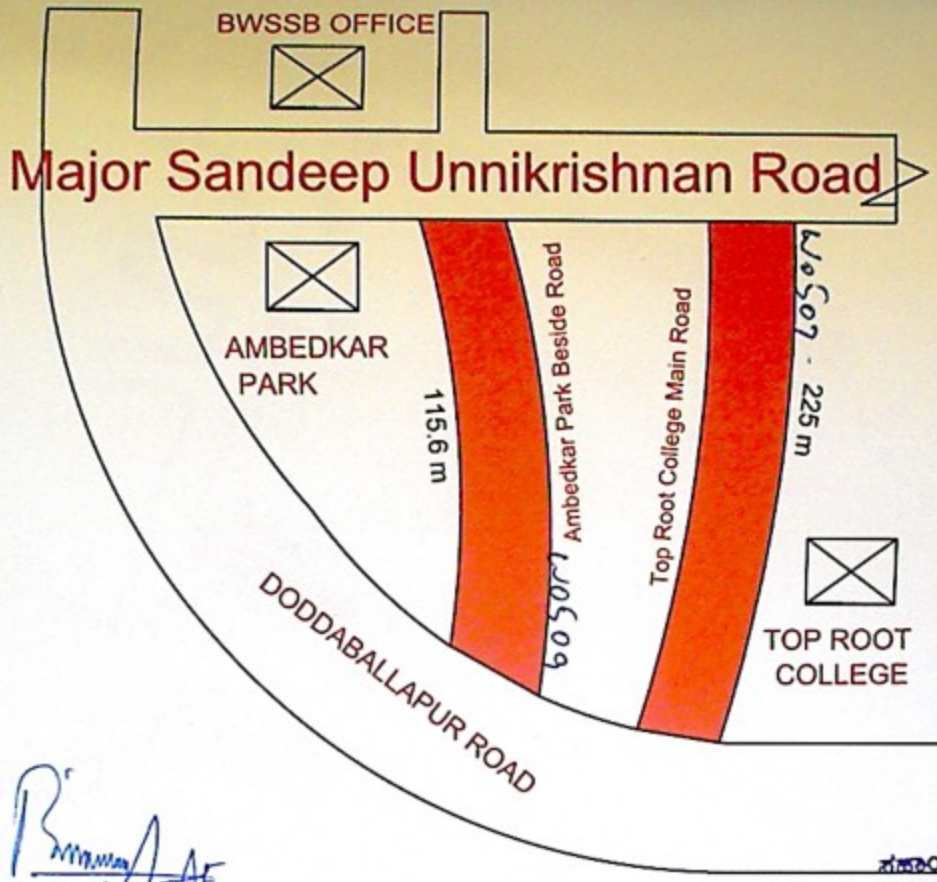

Location/Area/Ward: Ambedkar Park Sorrounding-Ward 03	CLIENT:	PMC:	CONTRACTOR:	Note:
PROJECT TITLE Restoration and Improvements of roads at MS Palya, Aishwarya Bakery Road, Giridhamanagara and Sorrounding Areas in Ward No. 03 of Yelahanaka New Town Sub Division (Package No 08)	**The Executive Engineer** Yelahanka Division Bruhat Bengaluru Mahanagara Palike (BBMP) Bangalore - 560064	**NANDI CONSULTANTS** 1st Main, 2nd Cross, Krushinagar Shimoga-577204	**SRI SAI Constructions**	FOR ASPHALT ROAD:

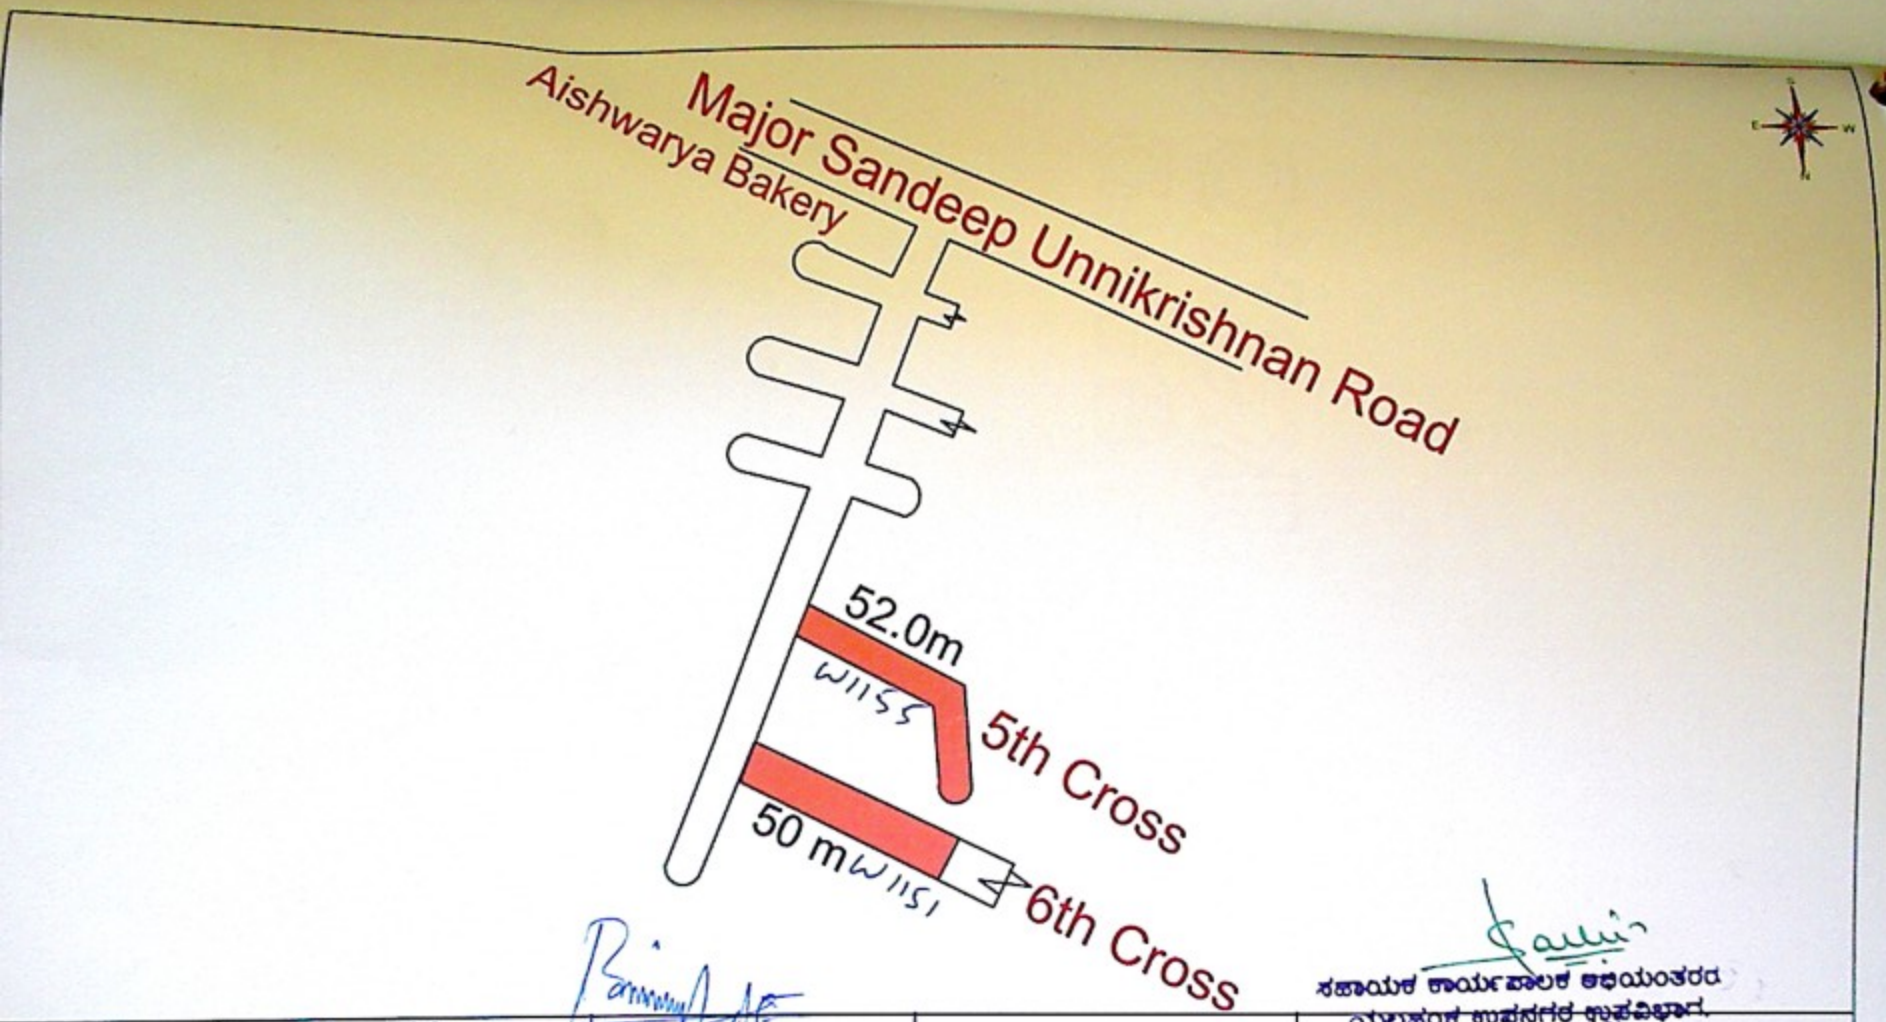

Location/Area/Ward: Near Aishwarya Bakery - Ward 03	CLIENT: BBMP	PMC: NANDI CONSULTANTS	CONTRACTOR: SRI SAI Constructions	FOR ASPHALT ROAD:
PROJECT TITLE Restoration and Improvements of roads at MS Palya, Aishwarya Bakery Road, Giridhamanagara and Sorrounding Areas in Ward No. 03 of Yelahanaka New Town Sub Division (Package No 08)	**The Executive Engineer** Yelahanka Division Bruhat Bengaluru Mahanagara Palike (BBMP) Bangalore - 560064	1st Main, 2nd Cross, Krushinagar Shimoga-577204		

ಸಹಾಯಕ ಕಾರ್ಯಪಾಲಕ ಅಭಿಯಂತರರ
ಯಲಹಂಕ ಉಪನಗರ ಉಪವಿಭಾಗ,
ಬೆಂಗಳೂರು-೫೬೦೦೬೪